
### Annex B - 4: Project Location Details Amended

Below are the location details for the aggregated solar PV project across thirty-three (34) government-owned buildings.

Site #	Location Description and GIS Link (click below for location link)	Estimated PV Capacity in Watts (DC)
C201	Co Educational Facility Prison	140,000
C202	Ministry of Public Works, Quarry Depot	500,000
C203	Prospect Primary School	150,000
C204	Sylvia Richardson Care Facility	90,000
C205	T. N. Tatem Middle School and Community Center	275,000
C206	West Gate Correctional Facility	195,000
C207	Berkeley Institute	400,000
C208	<u>Cedarbridge Academy</u>	500,000
C209	<u>Dellwood Middle School</u>	480,000
C210	Sandy's Secondary Middle School	360,000
C211	West Pembroke Primary School	180,000
C212	Hamilton Health Clinic and Annex	100,000
C213	Harrington Sound Primary School	125,000
C214	<u>Dalton E. Tucker Primary School</u>	100,000
C215	Elliot Primary School	190,000
C216	Fort Prospect Water Catchment	500,000
C217	<u>Lagoon Park Pre School</u>	60,000
C218	Lyceum Pre School/Francis Paton Primary School	110,000
C219	Paget Primary School	130,000
C220	Port Royal Primary School	60,000
C221	Prospect Pre School	35,000
C222	St George's Community Centre	70,000

Site #	Location Description and GIS Link (click below for location link)	Estimated PV Capacity in Watts (DC)
C224	Victor Scott Primary School	150,000
C225	Warwick - Post Office - Pre School - Clinic	90,000
C226	West End Primary School	130,000
C228	Global House	65,000
C229	Dame Lois Browne Evans Building	135,000
C230	Gilbert Institute Primary School	140,000
C231	Happy Valley Day Care Centre	30,000
<del>C233</del>	<del>Dame Marjorie Bean Hope Academy School</del>	<del>40,000</del>
C234	East End Primary School	130,000
C235	Devonshire Pre School Avocado Lodge	45,000
C236	Outerlea Farm - NEW	175,000
C237	Somerset Primary- NEW	128,000
C238	Summerhaven - NEW	118,000
	Total	6,086,000

# 21056 RMI SOLAR PROJECTS COVERSHEET & KEY

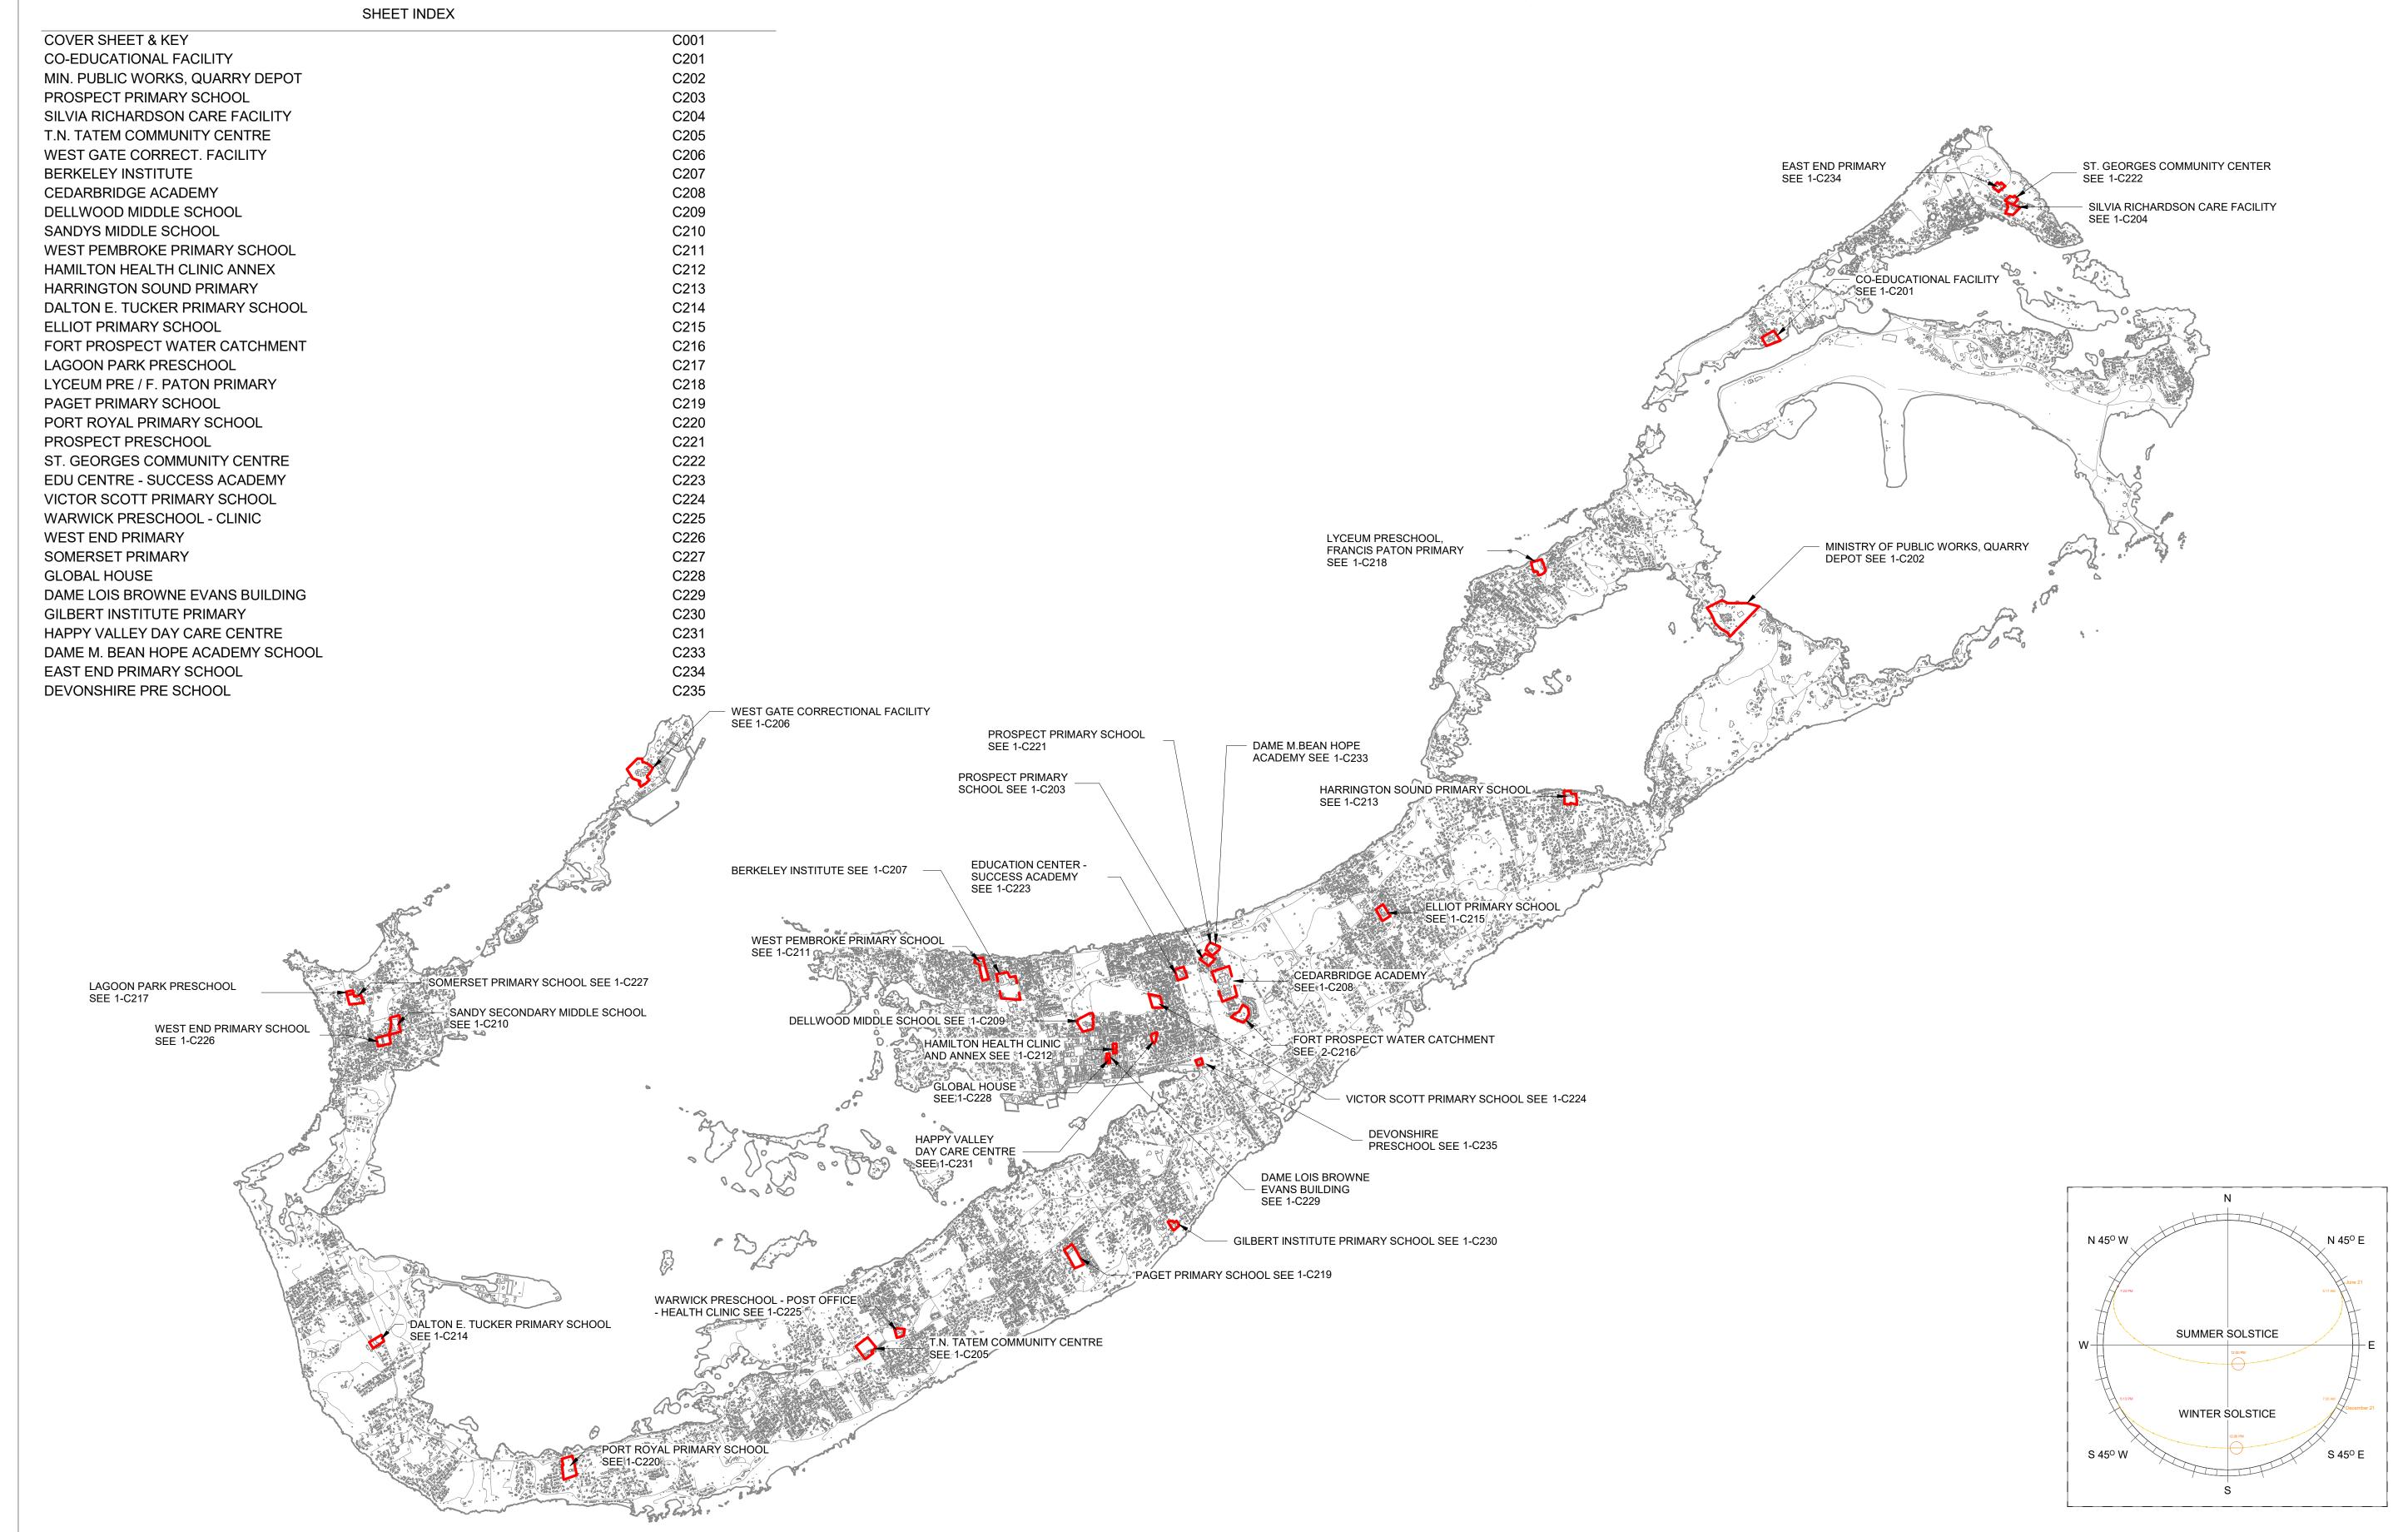


#### Copyright © 2022 Rocky Mountain Institute

This drawing is and shall remain the exclusive property of Rocky Mountain Institute (RMI) and the reproduction and/or use in whole or in part is prohibited without prior written consent from RMI.

The Contractor shall check and verify all levels, datum points, site conditions and dimensions and report any discrepancy or omission to the Engineer prior to

This drawing shall be read in conjunction with architectural and/or any other Consultants' documentation as may be applicable to the project. RMI shall not be held responsible for lack of coordination on the part of the Contractor.

**GENERAL NOTES:** 

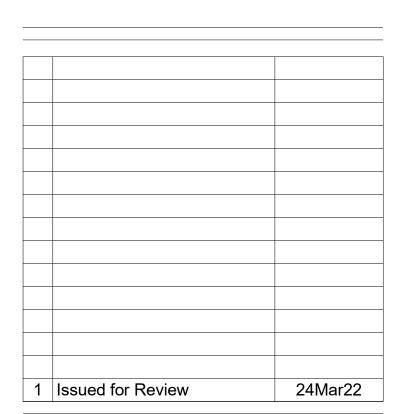



## **ROCKY MOUNTAIN INSTITUTE** 2490 JUNCTION PLACE, STE 200 BOULDER, CO 80302

PARED BY	CHECKED BY	APPROVED BY
MJ	CRB	CRB

## RMI SOLAR **PROJECTS**

# VARIOUS LOCATIONS ISLAND OF BERMUDA **COVER SHEET & KEY**

ISSUED FOR ISSU	ied for Review	
SCALE		SHEET SIZE
As indicated		24" x 36"
PROJECT NO	SHEET NO	REVISION
21056	C001	1